


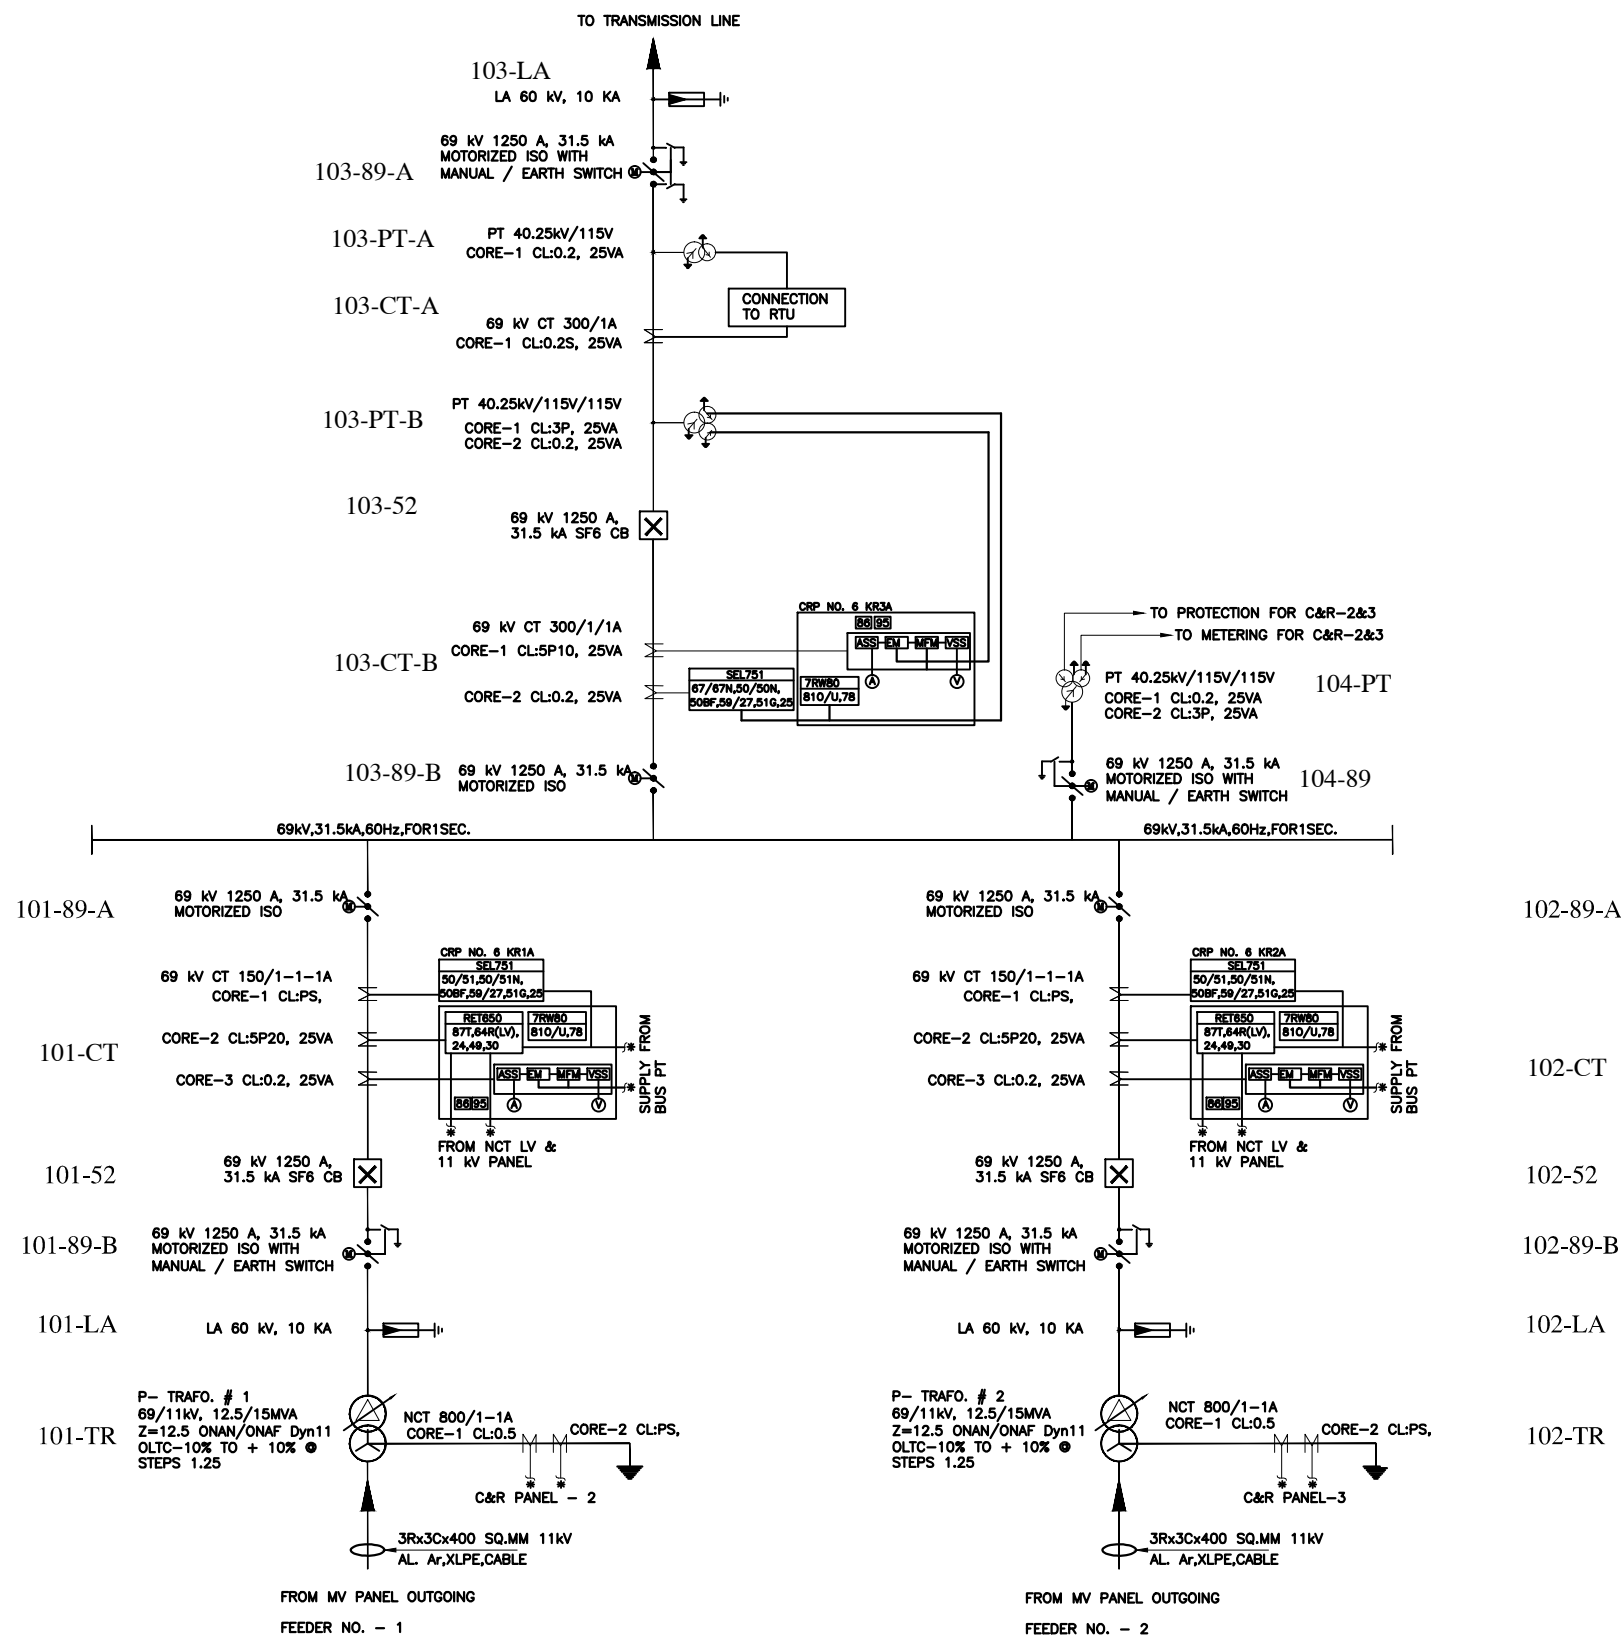

LEGENDS	
SYMBOLS	DESCRIPTIONS
	TRANSFORMER
	POTENTIAL TRANSFORMER
	CURRENT TRANSFORMER
	AMMETER
	VOLTMETER
	FREQUENCY METER
	AMMETER SELECTOR SWITCH
	VOLTMETER SELECTOR SWITCH
	TRIVECTOR METER
	EARTHING SWITCH
	ISOLATOR
	SF6CB
	INST. O/C RELAY
	INST. OVER CURRENT RELAY
	DIRECTIONAL OVER CURRENT RELAY
	DIRECTIONAL EARTH FAULT RELAY
	IDMT EARTH FAULT RELAY
	AC INVERSE TIME EARTH OVER CURRENT RELAY
	IDMT OVER CURRENT RELAY
	TRIP CIRCUIT SUPERVISION RELAY
	UNDER VOLTAGE RELAY
	OVER VOLTAGE RELAY
	ANNUNCIATOR RELAY
	UNDER/OVER FREQUENCY PROTECTION
	RESTRICTED EARTH FAULT RELAY
	BREAKER FAILURE RELAY
	VECTOR SURGE PROTECTION RELAY
	TRANSFORMER DIFFERENTIAL PROTECTION
	CHECK SYNCHRONIZING RELAY
	MASTER TRIP RELAY
	TRIP CIRCUIT SUPERVISION RELAY
	OVER EXCITATION PROTECTION
	INDICATING LAMP
	RED, YELLOW, BLUE PHASE
	FEEDER PROTECTION RELAY-SEL
	TRANSFORMER PROTECTION RELAY-ABB
	FEEDER PROTECTION RELAY-SIEMENS

AS BUILT
CONTROL COPY

10.05.2016	As Built
R3 10.09.2015	As Per Client Requirement
R2 21.07.2015	AS PER NGCP REQUIREMENT
R1 20.07.2015	FOR APPROVAL
R0 14.07.2015	FOR PRIMARILY DESIGN

DRAWING NO.- SWD-DGO-28.59 MWp-PH-E-DWG-102

PRESIDENT

DEVELOPMENT OF SOLAR PHOTO VOLTAIC
PLANT DIGOS, PHILIPPINE

69 kV SINGLE LINE DIAGRAM