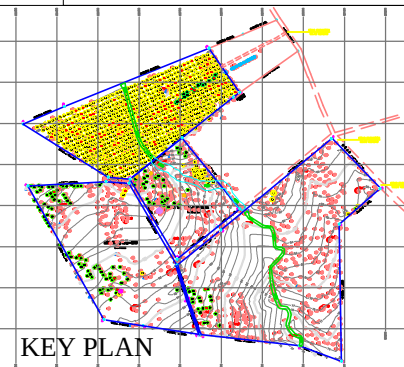
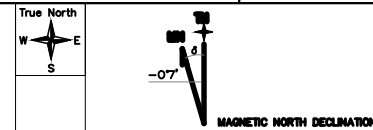
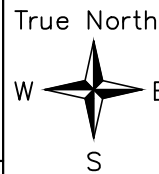


PITCH DETAIL

LEGEND :-

SYMBOL	DESCRIPTION
	MOD.STRUCTURE
	3 M WIDE WBM ROAD WITH 0.5M + 0.5 SHOULDER
	3 M WIDE BITUMEN ROAD WITH 0.5M + 0.5 SHOULDER
	INVERTER STATION
	FENCING
	ACTUAL CREEK


NOTES:

1. ALL DIMENSIONS ARE IN METER.
2. MODULE RATING : 310Wp
3. NO OF MODULES PER STRINGS : 21
4. TOTAL NUMBER OF STRINGS : 4392 Nos
5. TOTAL NUMBER OF MODULES : 92232 Nos
6. TOTAL NUMBER OF TABLES : 1464 Nos
7. PITCH : 7.5 Mtrs
8. TOTAL NO OF 917 kW INVERTERS : 27 Nos
9. DC CAPACITY : 28.59 MWp
10. AC CAPACITY : 24.75 MW
11. TOTAL NO OF INVERTER TRANSFORMER 2 MVA : 13 Nos
12. TOTAL NO OF INVERTER TRANSFORMER 1 MVA : 01 Nos

AS BUILT

CONTROL COPY

Block - Name	Per Block Structure Detail	Per Inverter Structure Detail
Block-1	110	55
Block-2	110	55
Block-3	110	55
Block-4	108	54
Block-5	108	54
Block-6	108	54
Block-7	108	54
Block-8	108	54
Block-9	108	54
Block-10	108	54
Block-11	162	54
Block-12	108	54
Block-13	108	54
Total	1464	1464

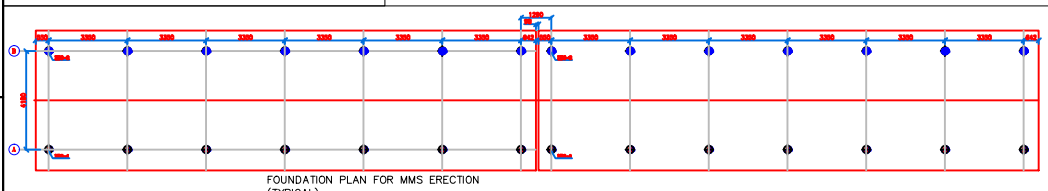

No.	DATE	REVISIONS	REMARKS
1	20.04.2016	As Built	
2	14.09.2015	As Per Revised Site Survey	
3	11.09.2015	As Per Site Survey	
4	09.09.2015	As Per Client Discussion	
5	31.08.2015	As Per Site Requirement	
6	31.07.2015	As Per Client Requirement	
7	14.07.2015	For Preliminary Design	

STERLING AND WILSON LTD.	DRAWING NO.- SWD-DGO-28.59 MWp-PH-E-DWG-105
enfinity	PRESIDENT

PROJECT TITLE	SHEET CONTENT
DEVELOPMENT OF SOLAR PHOTO VOLTAIC PLANT DIGOS, PHILIPPINE	GENERAL DEVELOPMENT PLAN