


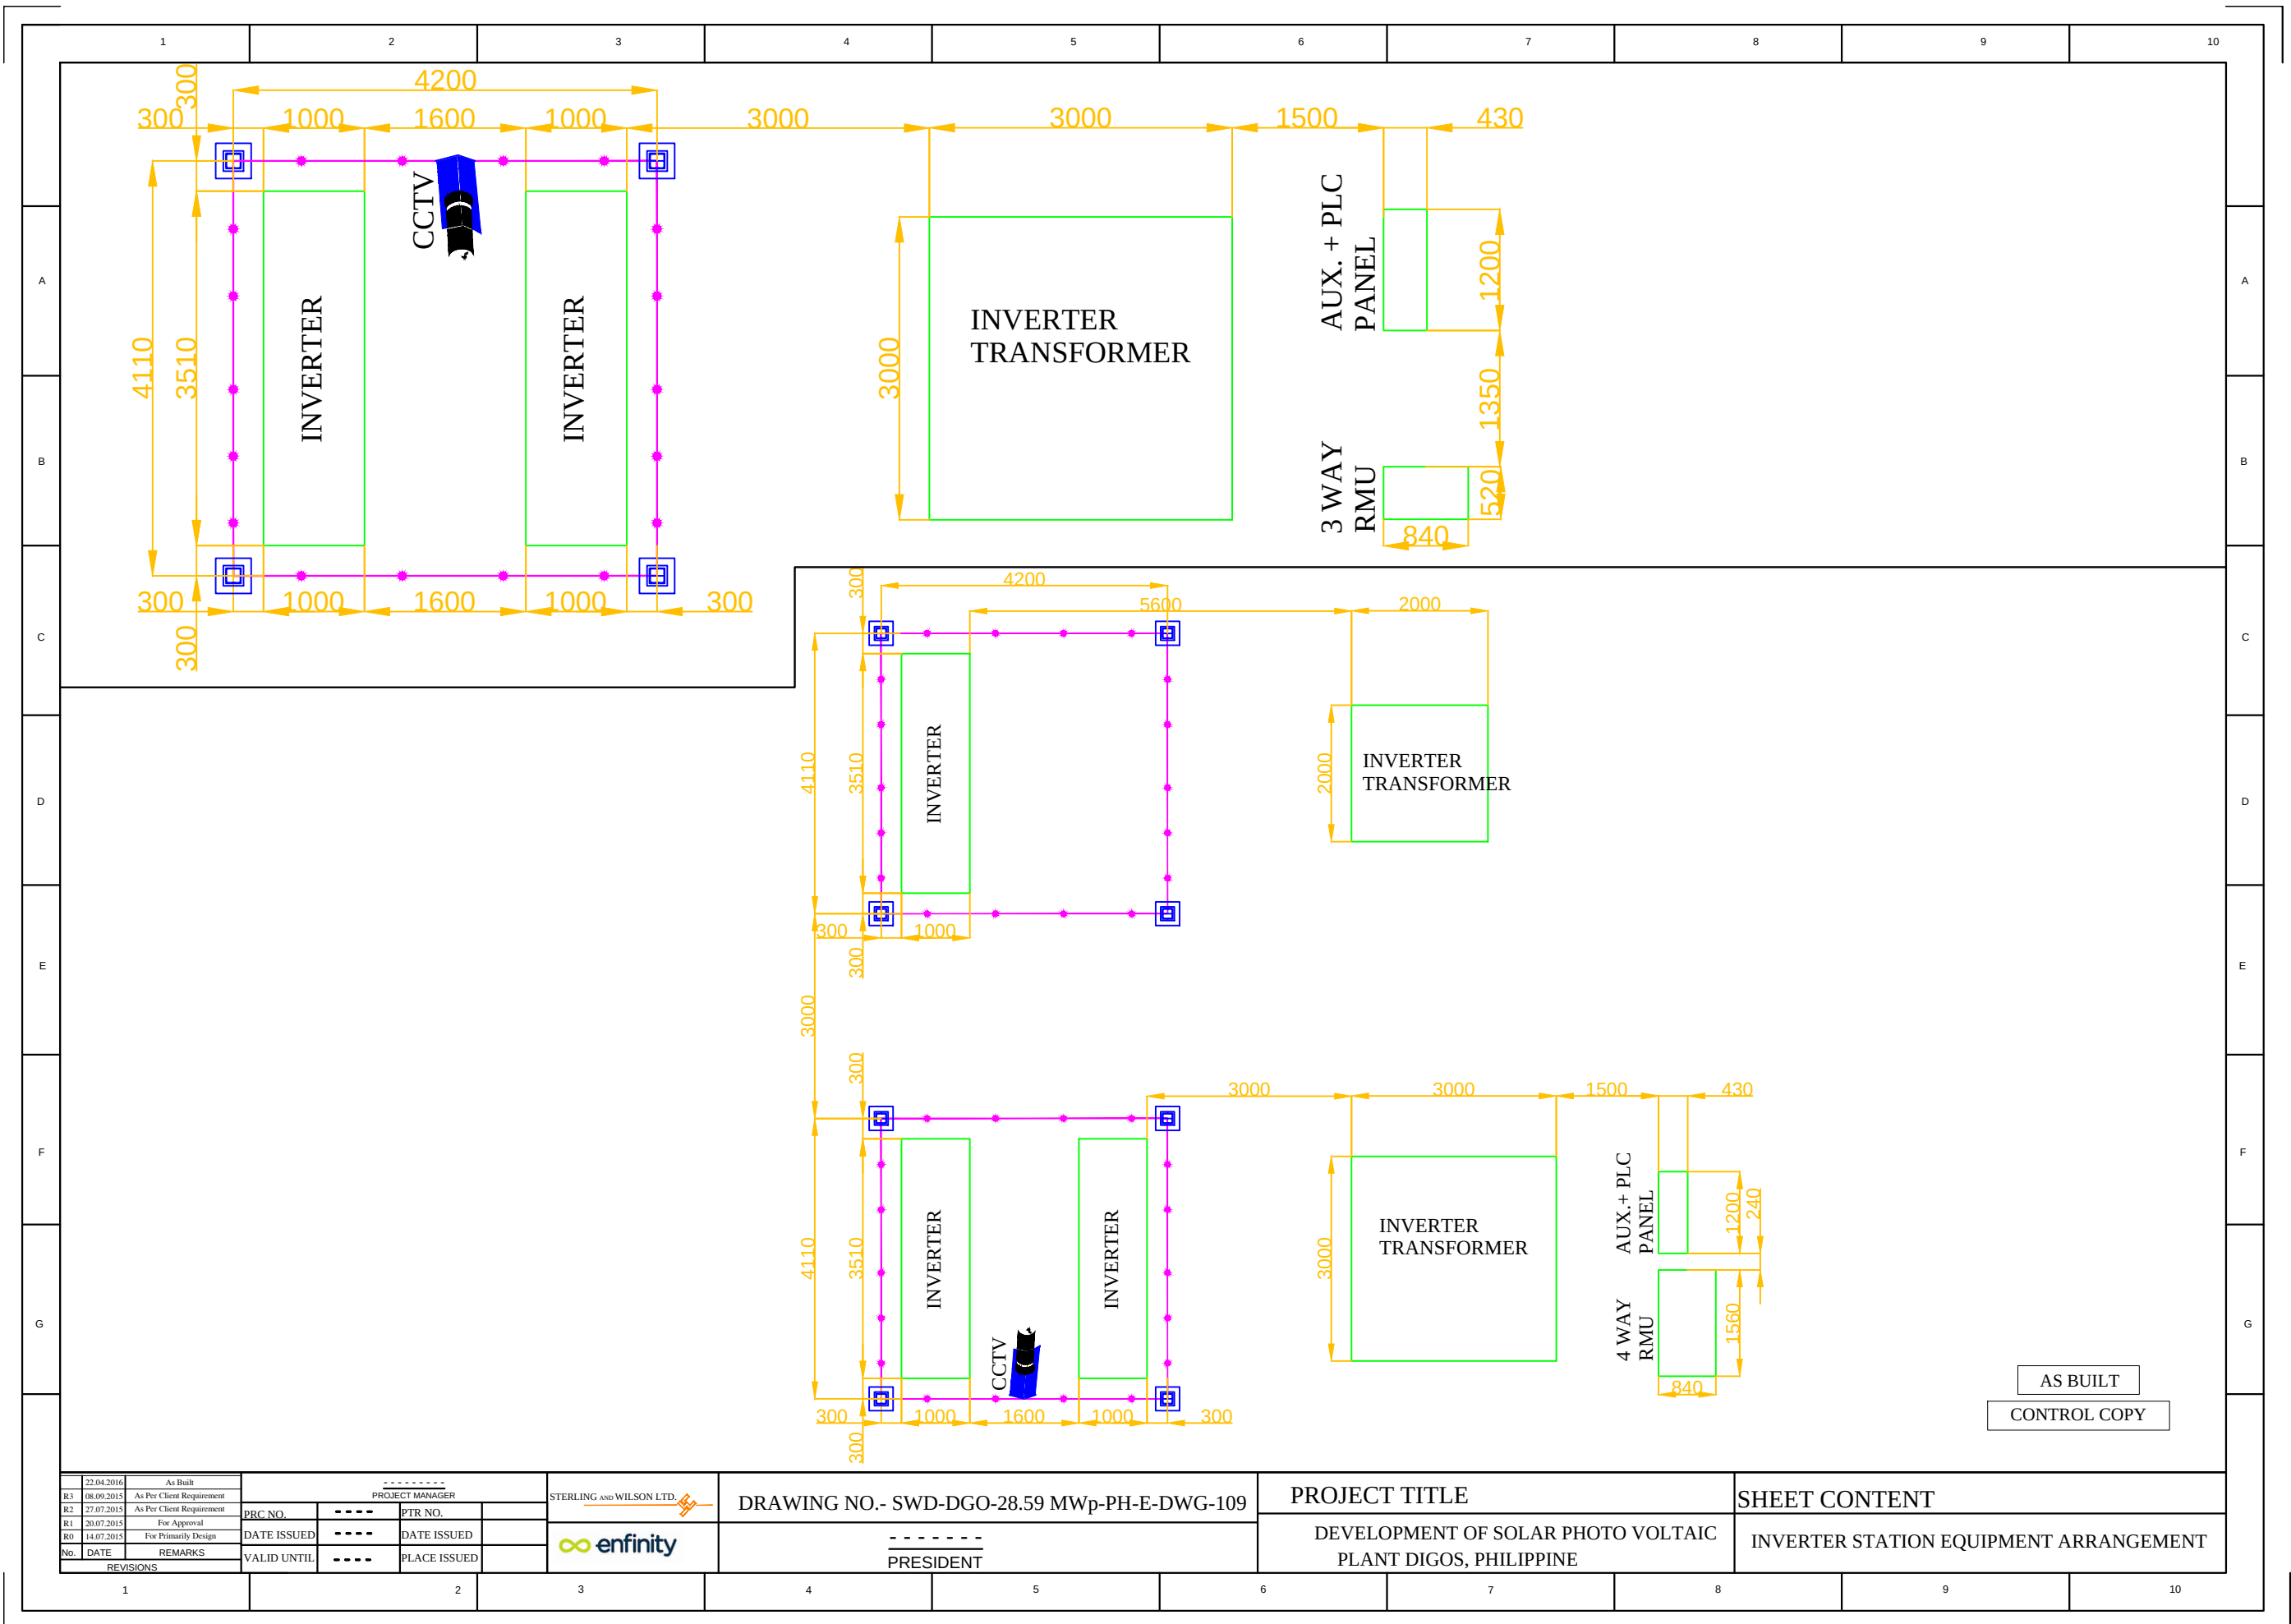

AS BUILT
CONTROL COPY

22.04.2016		As Built		-----				STERLING AND WILSON LTD.	DRAWING NO.- SWD-DGO-28.59 MW _p -PH-E-DWG-109	PROJECT TITLE	SHEET CONTENT
R3	08.09.2015	As Per Client Requirement		PROJECT MANAGER							
R2	27.07.2015	As Per Client Requirement		PRC NO.	----	PTR NO.		enfinity		DEVELOPMENT OF SOLAR PHOTO VOLTAIC PLANT DIGOS, PHILIPPINE	INVERTER STATION EQUIPMENT ARRANGEMENT
R1	20.07.2015	For Approval		DATE ISSUED	----	DATE ISSUED					
R0	14.07.2015	For Preliminary Design									
No.	DATE	REMARKS		VALID UNTIL	----	PLACE ISSUED					
REVISIONS											