


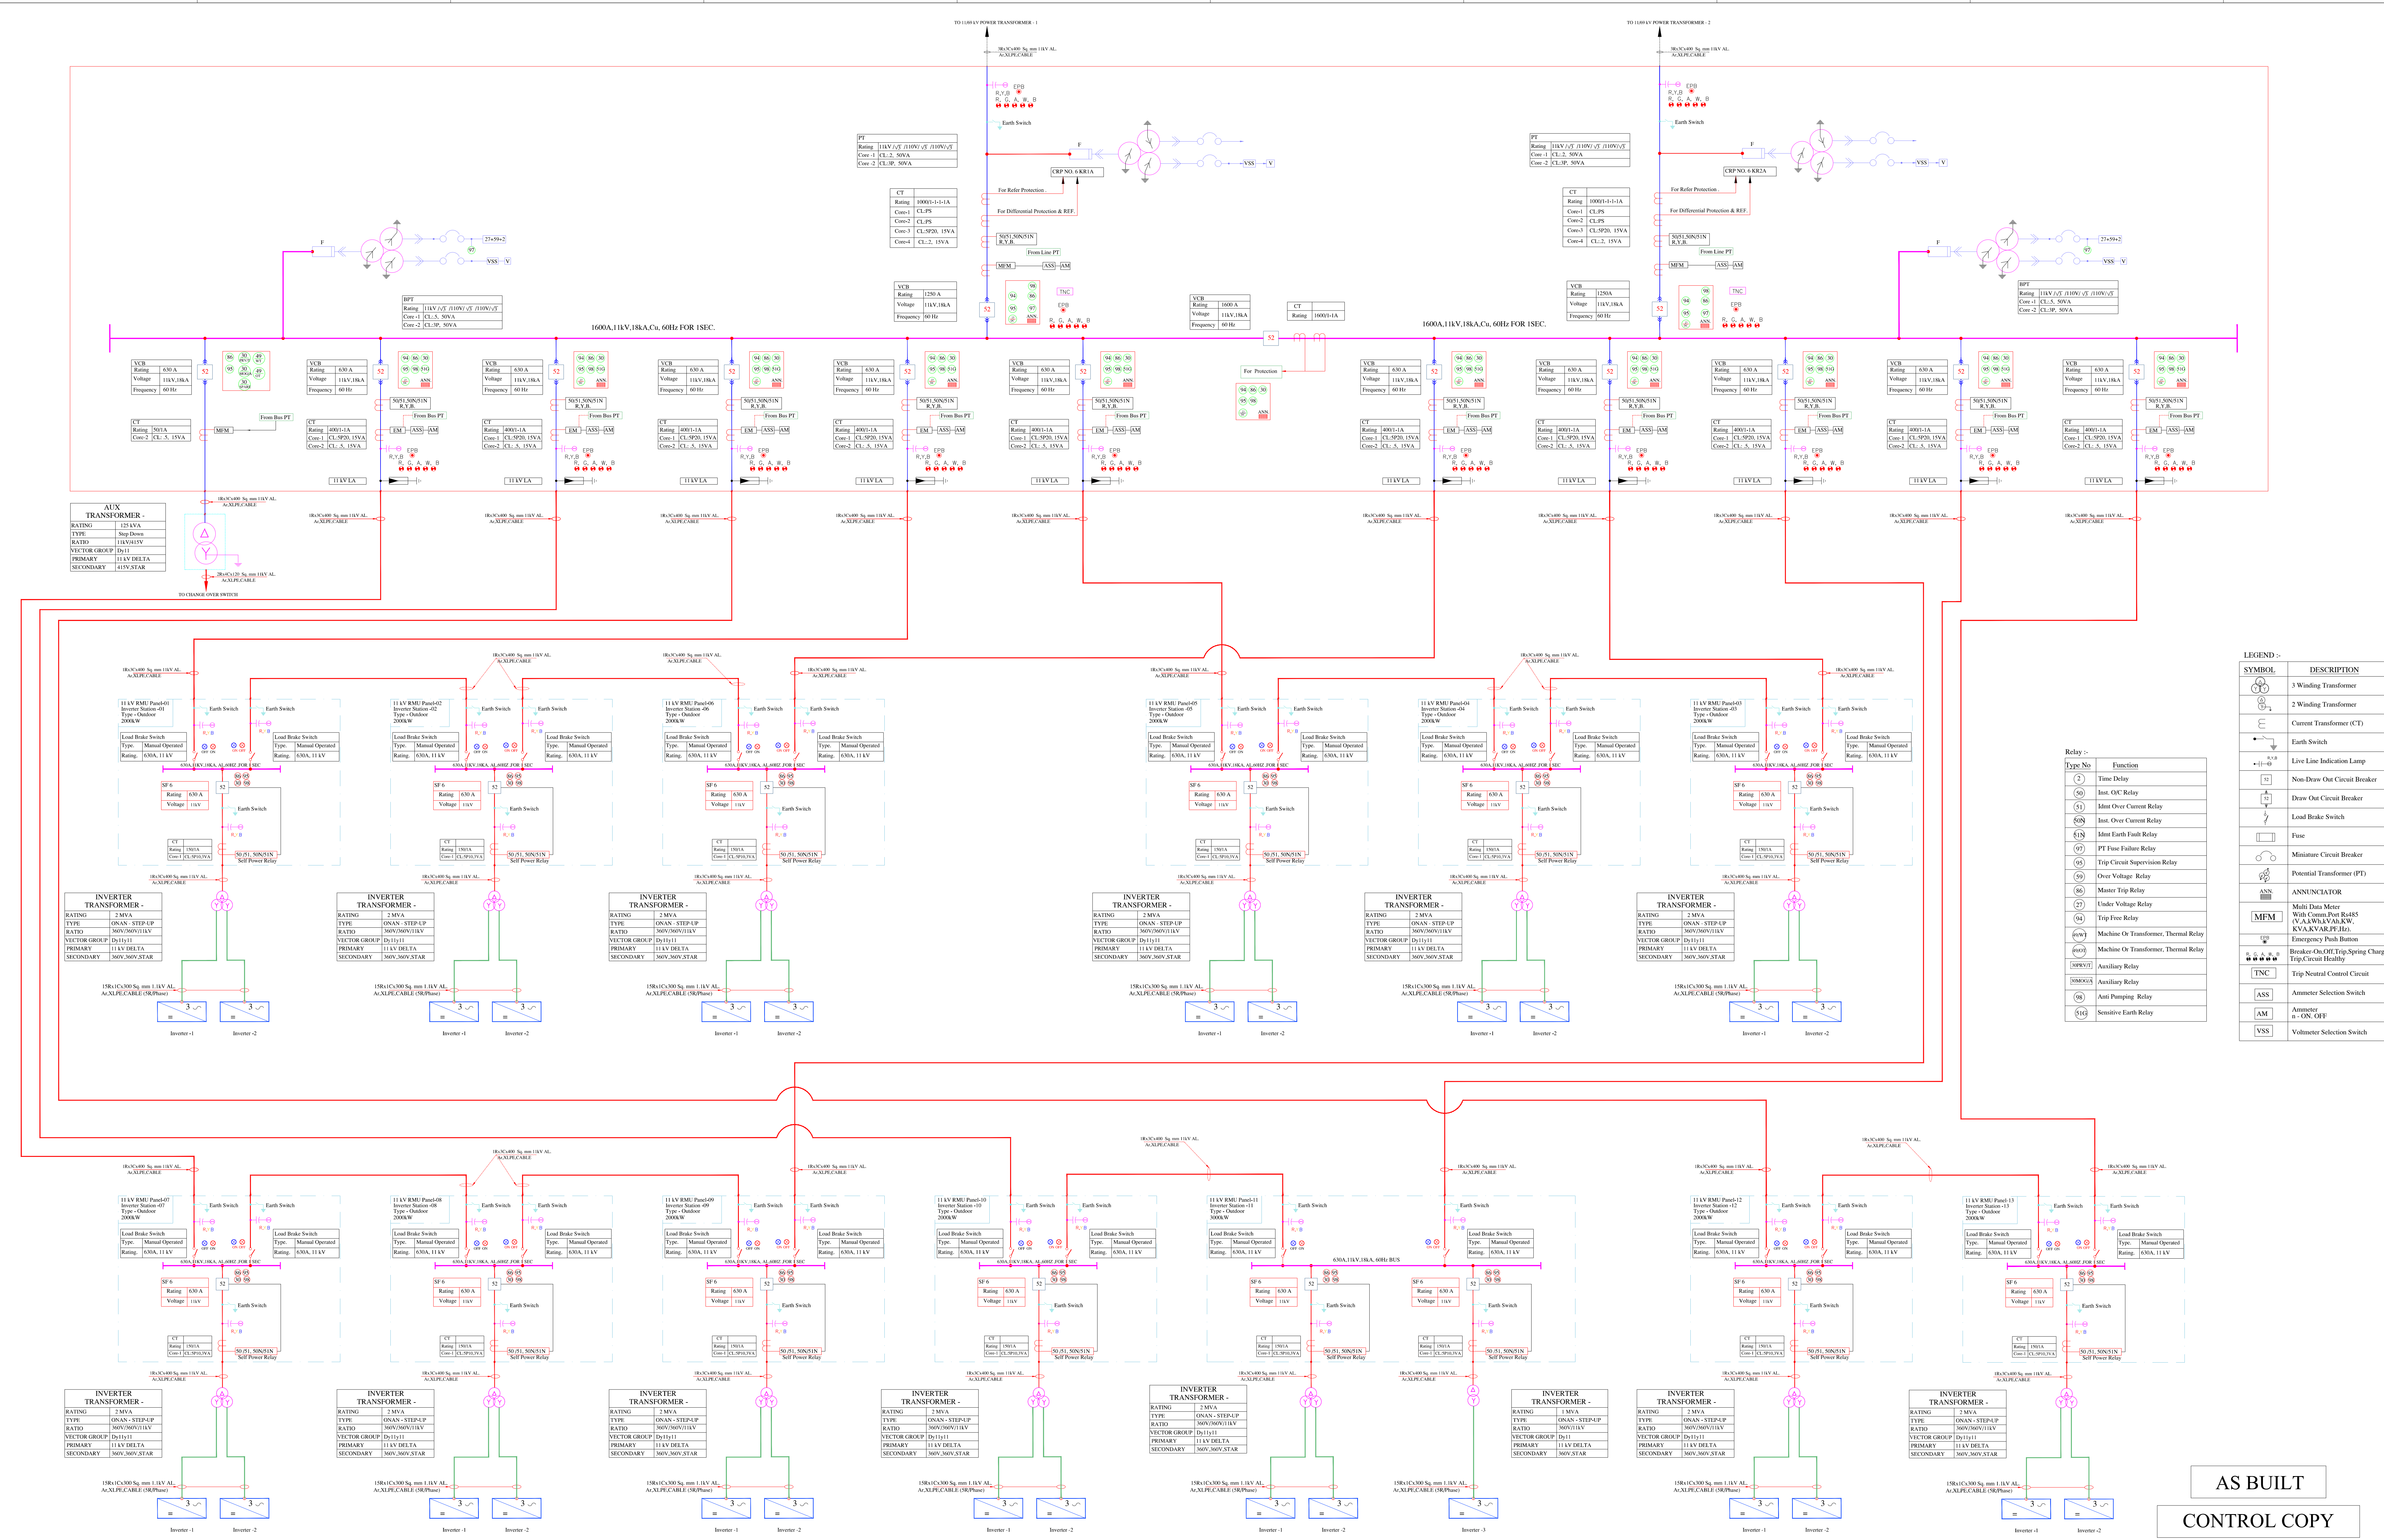

LEGEND:	
SYMBOL	DESCRIPTION
	3 Winding Transformer
	2 Winding Transformer
	Current Transformer (CT)
	Earth Switch
	Live Line Indication Lamp
	Draw Out Circuit Breaker
	Lok Switch
	Fuse
	Miniature Circuit Breaker
	Potential Transformer (PT)
	ANNUNCIATOR
	Multi Data Meter with 4 or 8 Channels (V, A, W, VAR, kW, kVAR, kVA, PF, Hz)
	Emergency Stop Push Button
	Energy On/Off Trip Switching Circuit Control
	TriP Neutral Control Circuit
	Ammeter Selection Switch
	Ammeter n - ON - OFF
	Voltmeter Selection Switch

AS BUILT

CONTROL COPY

20.04.2016		As Built		PROJECT MANAGER		STERLING AND WILSON LTD.	DRAWING NO.- SWD-DGO-28.59 MWp-PH-E-DWG-101	PROJECT TITLE	SHEET CONTENT
R3	10.09.2015	As Per NGPC Requirement							
R2	27.07.2015	As Per client Requirement		PRC NO.	- - -	PTR NO.		DEVELOPMENT OF SOLAR PHOTO VOLTAIC PLANT DIGOS, PHILIPPINE	MV SINGLE LINE DIAGRAM
R1	20.07.2015	For Approval		DATE ISSUED	- - -	DATE ISSUED			
R0	14.07.2015	For Primarily Design							
No.	DATE	REMARKS		VALID UNTIL	- - -	PLACE ISSUED			
REVISIONS							enfinity	----- PRESIDENT	